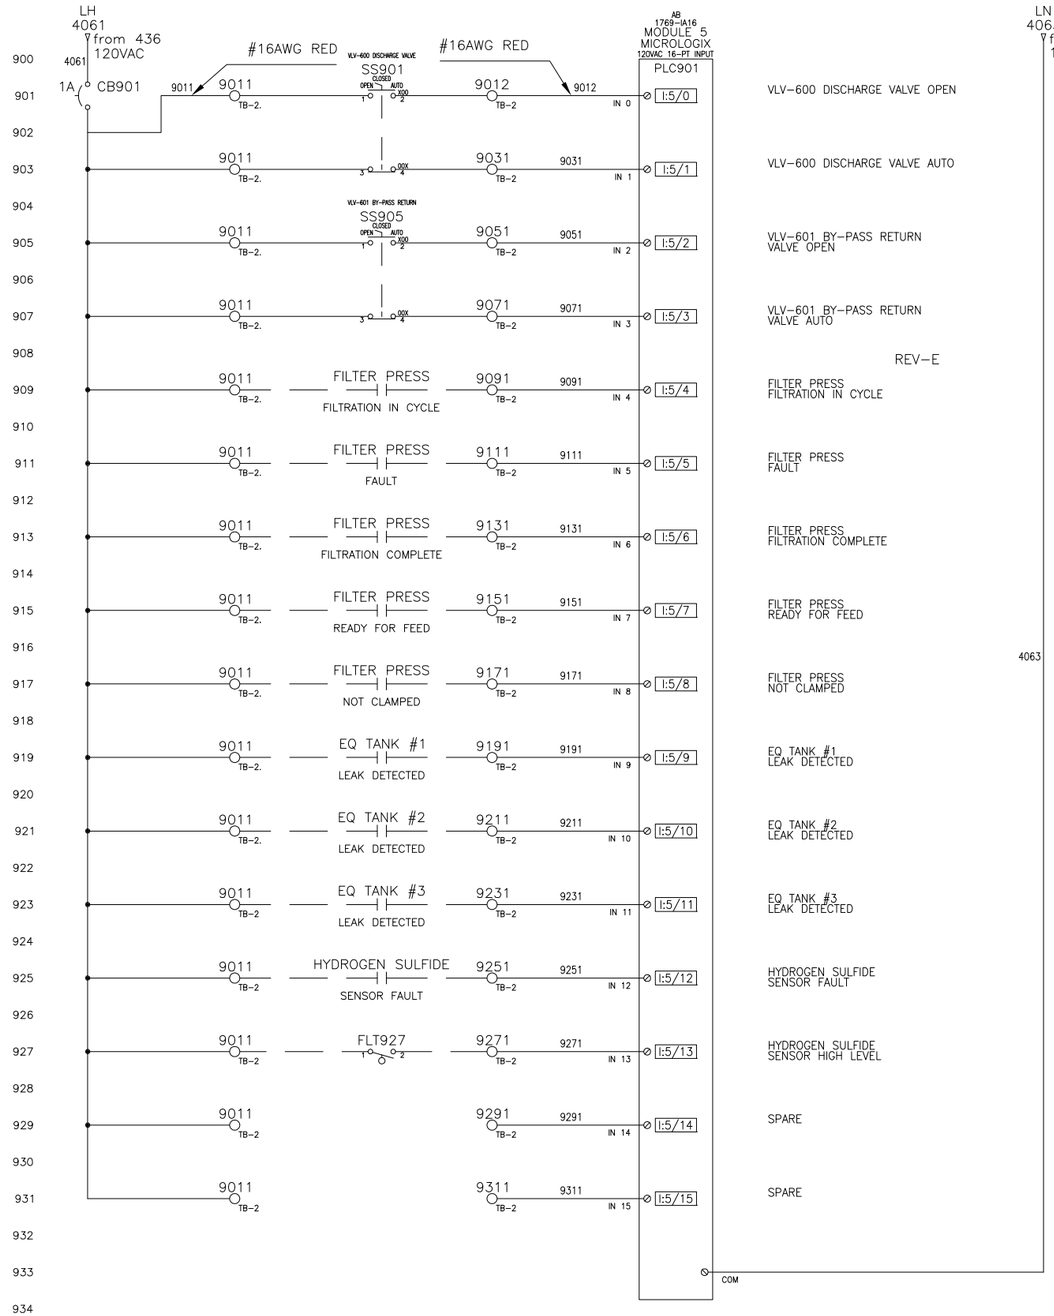

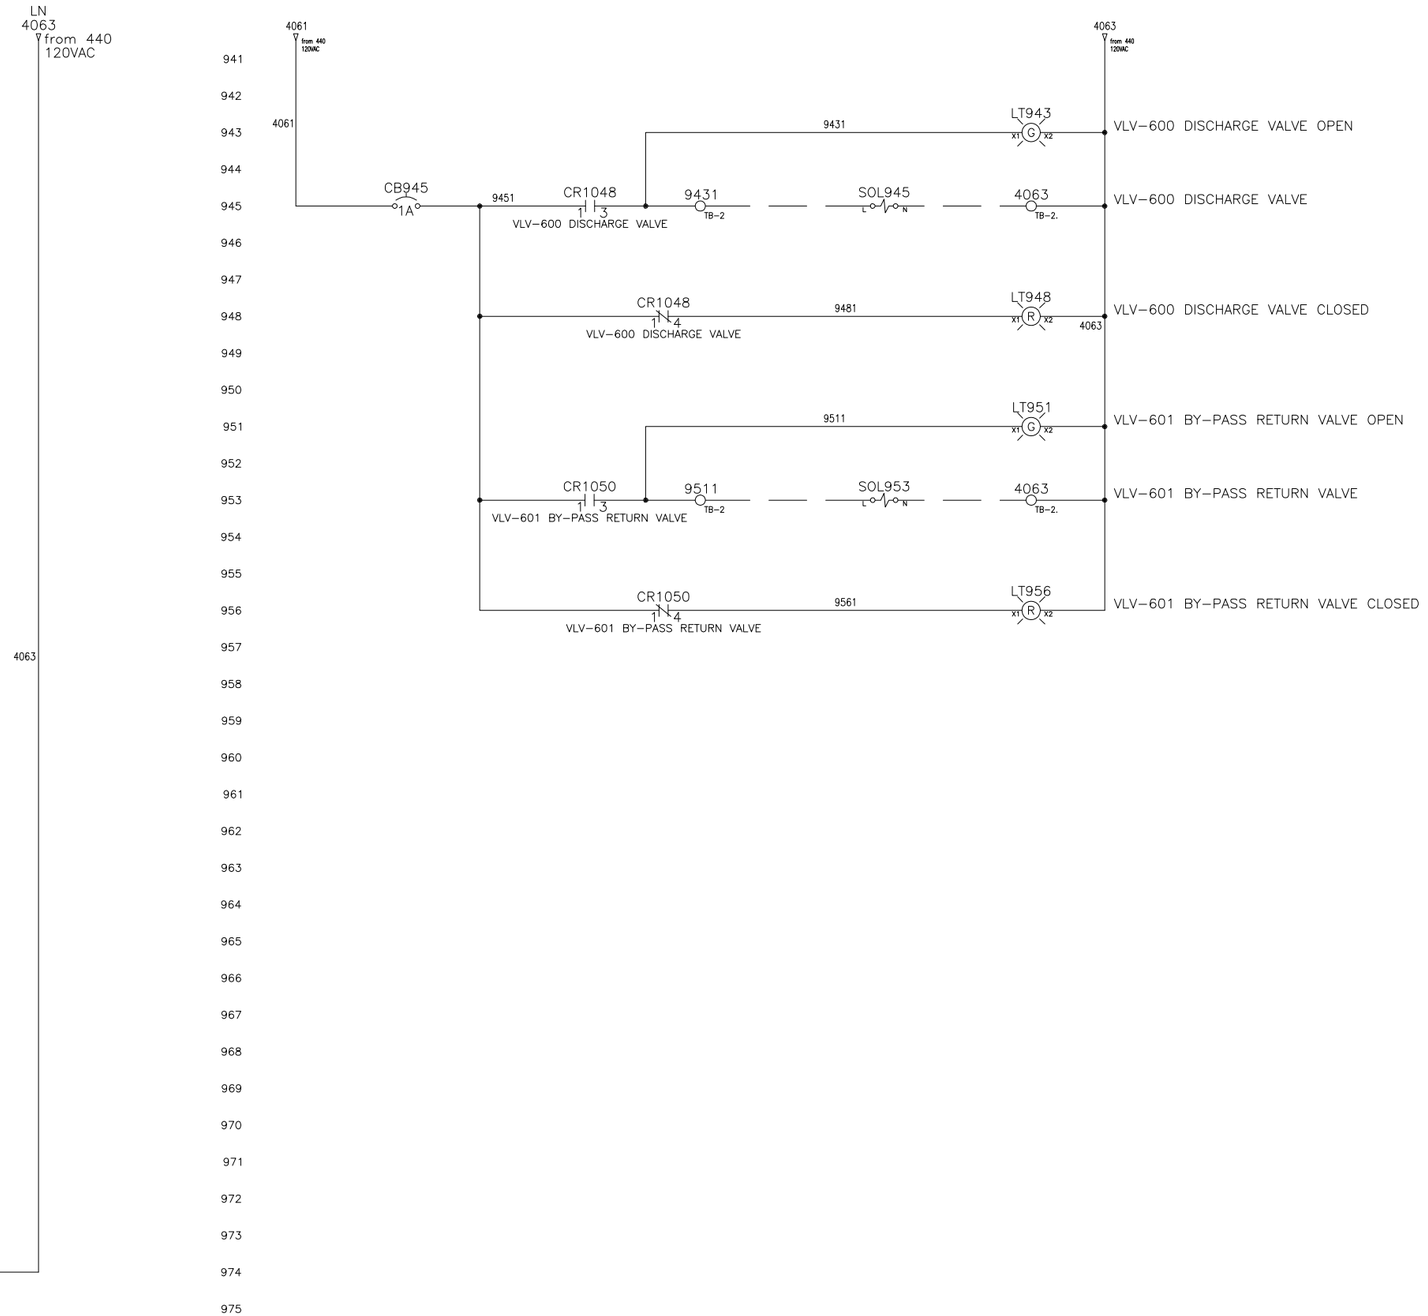

REV	DATE	CHANGES
F	7/29/09	REVISE PER FIELD MODIFICATIONS
E	4/6/09	REVISE PER FIELD MODIFICATIONS
D	2/26/09	ADD VLV-600 AND VLV-601
C	8/20/08	AS BUILT
B	5/29/08	REVISE PER COMMENTS 5/23/08
A	2/15/08	REVISE PER COMMENTS 2/11/08

HYDRO-FLO TECHNOLOGIES INC.
3985 Commerce Drive, St. Charles, IL 60174
www.hydroflotech.com

THIS DRAWING IS THE PROPERTY OF HYDRO-FLO TECHNOLOGIES, INC. AND IT IS LOANED UPON THE EXPRESS CONDITION THAT IT SHALL NOT BE COPIED OR REPRODUCED IN ANY MANNER, THAT IT SHALL NOT BE SUBMITTED TO OTHERS FOR EXAMINATION WITHOUT THE CONSENT OF THIS COMPANY, THAT IT SHALL NOT BE USED IN ANY OTHER WAY DETRIMENTAL TO THE INTERESTS OF THIS COMPANY AND THAT IT SHALL BE RETURNED UPON DEMAND.

P2511 SYSTEM PANEL

TOLERANCES	SCALE: NONE	DRAWN: DDO	DATE: 12/3/07
UNLESS NOTED: ±1/16" ALL DIMENSIONS IN INCHES		APPRVD:	DATE:
JOB: 07-2809	CUSTOMER:	DRAWING NUMBER: 07-2809-E01	SHT NO: 9 OF 20